

III Maryland Avenue | Rockville, Maryland 20850-2364 | 240-314-5000 www.rockvillemd.gov

Development Review Comments

May 16, 2023
PAM2023-00148
Submission Review Comments
14225 Glen Mill Road – Parallel Hope Schools

The following are Development Review comments from City of Rockville staff related to the project submission.

Reviewing Staff

Planning & Development Services (CPDS)

Project Manager:

Nelson Ortiz, Principal Planner nortiz@rockvillemd.gov

Comprehensive Planning:

Katie Gerbes (KG), Comprehensive Planning Manager kgerbes@rockvillemd.gov

Forestry Reviewer:

Shaun Ryan (SR), Development Review Supervisor sryan@rockvillemd.gov

Fire Reviewer:

Charles Biggus (CB), Fire Plans Examiner cbiggus@rockvillemd.gov

Building Reviewer:

Chris Dempwolf (CD), Buildings Plan Examiner Supervisor cdempwolf@rockvillemd.gov

Dept. of Public Works (DPW)

Engineering Reviewer:

Sean Murphy (SM), Principal Civil Engineer smurphy@rockvillemd.gov

Traffic and Transportation Reviewers:

Andrew Luetkemeier (AWL), Principal Transportation Engineer <u>aluetkemier@rockvillemd.gov</u>

Faramarz Mokhtari (FM), Senior Transportation Planner fmokhtari@rockvillemd.gov PAM2023-00148 Development Review Letter May 16, 2023

Housing and Community Development (HCD)

Housing Reviewer:

Punam Thukral (PT), Housing Specialist pthukral@rockvillemd.gov

Recreation and Parks (RPD)

Parks Reviewer:

Christine Henry (CH), Deputy Director chenry@rockvillemd.gov

PDS Comments

Development & Zoning

- 1. The purpose of a Pre-Application Meeting (PAM) with the Development Review Committee (DRC) is not to approve/disapprove aspects of a development plan. It is a meeting that provides an early opportunity for City Staff to give general advice to an applicant in the preparation of a site plan, project plan, or special exception, to discuss the application process and schedule going forward, and to address any concerns raised by the community. Staff strives to identify major issues but does not perform a full and complete review for compliance with all aspects of the code, which is done at the application phase.
 - a. The subject site is currently designated R-D (Residential Detached) by the Comprehensive Plan and is zoned R-400 (Residential Estate).
 - b. A new Educational institution, private is proposed.
 - c. Per Sec. 25.10.03, Education institution, private is a permitted use with an approved special exception in the R-400 zone.
- 2. Land Use Planning Process:
 - a. Special Exception application is required following finalization of PAM2023-00148 to permit a new private education institution in the R-400 Zone. The new institution (school) will be located within the existing church on the subject site.
 - b. Following approval of the Special Exception application, a minor site plan amendment application will be required per Sec. 25.05.07 (Amendments to approved development) and Article 7 (Procedures for Site Plans and Project Plans, Special Exception and other permits).
 - c. Following approval of the minor site plan amendment application, a "signature set" will be required for final approval.
- 3. Land Use Review Timelines:
 - a. Special Exception Application: initial submittal review by staff is 4 weeks; subsequent reviews are 2-3 weeks; final submittal due 5 weeks before the initial Planning Commission hearing. Final decision is by Board of Appeals.
 - b. Minor Site Plan Amendment: initial submittal review is 3 weeks; subsequent reviews are 2 weeks.
 - c. Minor Site Plan Amendment Signature Set: initial submittal review is 1 week; subsequent reviews are 1 week.
 - d. Total typical review timeline is highly variable depending on applicant submittal timelines and responsiveness to City comments and requests.
- 4. The applicant's narrative should address how this proposed use will meet each of the SPX findings from Section 25.15.01.a.2. The narrative should also include a description of operations for the church (service hours, meetings, after hours event, etc.) to gauge where facilities and operations might overlap between the two uses.

PAM2023-00148 Development Review Letter May 16, 2023

- 5. Will both uses utilize all 11,196 square feet of the existing building? Are there parts of the building that will be used solely by the church, by the school? If applicable, identify separate locations on site plan.
- 6. Application documents should be reconciled. For example, the building square footage and parking counts indicated on the application form do not coincide with the amounts on the site plan. The ROW widths on the site plan do not coincide with the dimensions on the plat.
- 7. The site plan should be updated to address all requirements of the proposed new use, specify the Zoning district, and demonstrate compliance with the development standards table from Section 25.10.05.a.
- 8. Applicant will need to comply with the bicycle parking requirements from Article 16 of the Zoning Ordinance. The number of short-term and long-term bicycle parking spaces are based on proposed classrooms per Section 25.16.03. The placement and installation of the bicycle facilities should be consistent with Section 25.16.09 and should be identified in the site plan.
- 9. Add a vehicle and bicycle parking table on the site plan. Table should provide parking calculations and specify required and proposed/existing parking.
- 10. If proposed, identify the location of a playground or play area for the school. Depending on the location, safe access between the play area to the school building should be provided and illustrated on the site plan.
- 11. Update the site plan to remove "proposed addition" since it already exists.

Comprehensive Planning (KG)

No comments. There is no language in the Comprehensive Plan or any of Rockville neighborhood plans that directly supports, nor directly conflicts with the application.

Forestry (SR)

1. See plan markups for comments.

Fire (CB)

1. See plan markups for comments.

Building (CD)

1. No comments at this time.

DPW Comments

Engineering (SM)

1. See site plan markups.

Traffic and Transportation (AWL/FM)

1. See markups on the submittal documents for site plan comments and CTR comments.

HCD Comments

Housing (PT)

1. No comments

RPD Comments

Parks (CH)

1. No comments

External Agencies

MCDOT Comments

- Are additional access points being considered in addition to the existing one on Glen Mill Road?
- The access to the Lakewood Elementary school is right next to this entrance to a proposed school (church was fine with weekend-only traffic; the school would generate additional weekday traffic)
- 3. Having 2 adjacent unrestricted access points creates multiple conflict points and would not be acceptable (has the developer considered the option to work with Lakewood Elementary to combine both the access points)
- 4. MCDOT would like to review the counts at the intersection of Glen Mill Road and Wootton Parkway (at the TIS stage).
- 5. The County's Bicycle Master Plan recommends a sidepath along their Glen Mill Road street frontage. The applicant should either construct it or pay a fee in lieu. The path should be 10 feet wide minimum. Here's the cross section for their side of the road:


10.5 foot travel lane

6 foot tree buffer

10 foot sidepath (shared use path)

2 foot maintenance buffer.

Note: At the time of the next submittal, the applicant will need to provide a point-by-point response letter noting how the staff review comments have been addressed. Comments provided in letter format can be addressed letter format. Comments provided in the plans should be addressed via plan markups rather than letter format. See attached example.

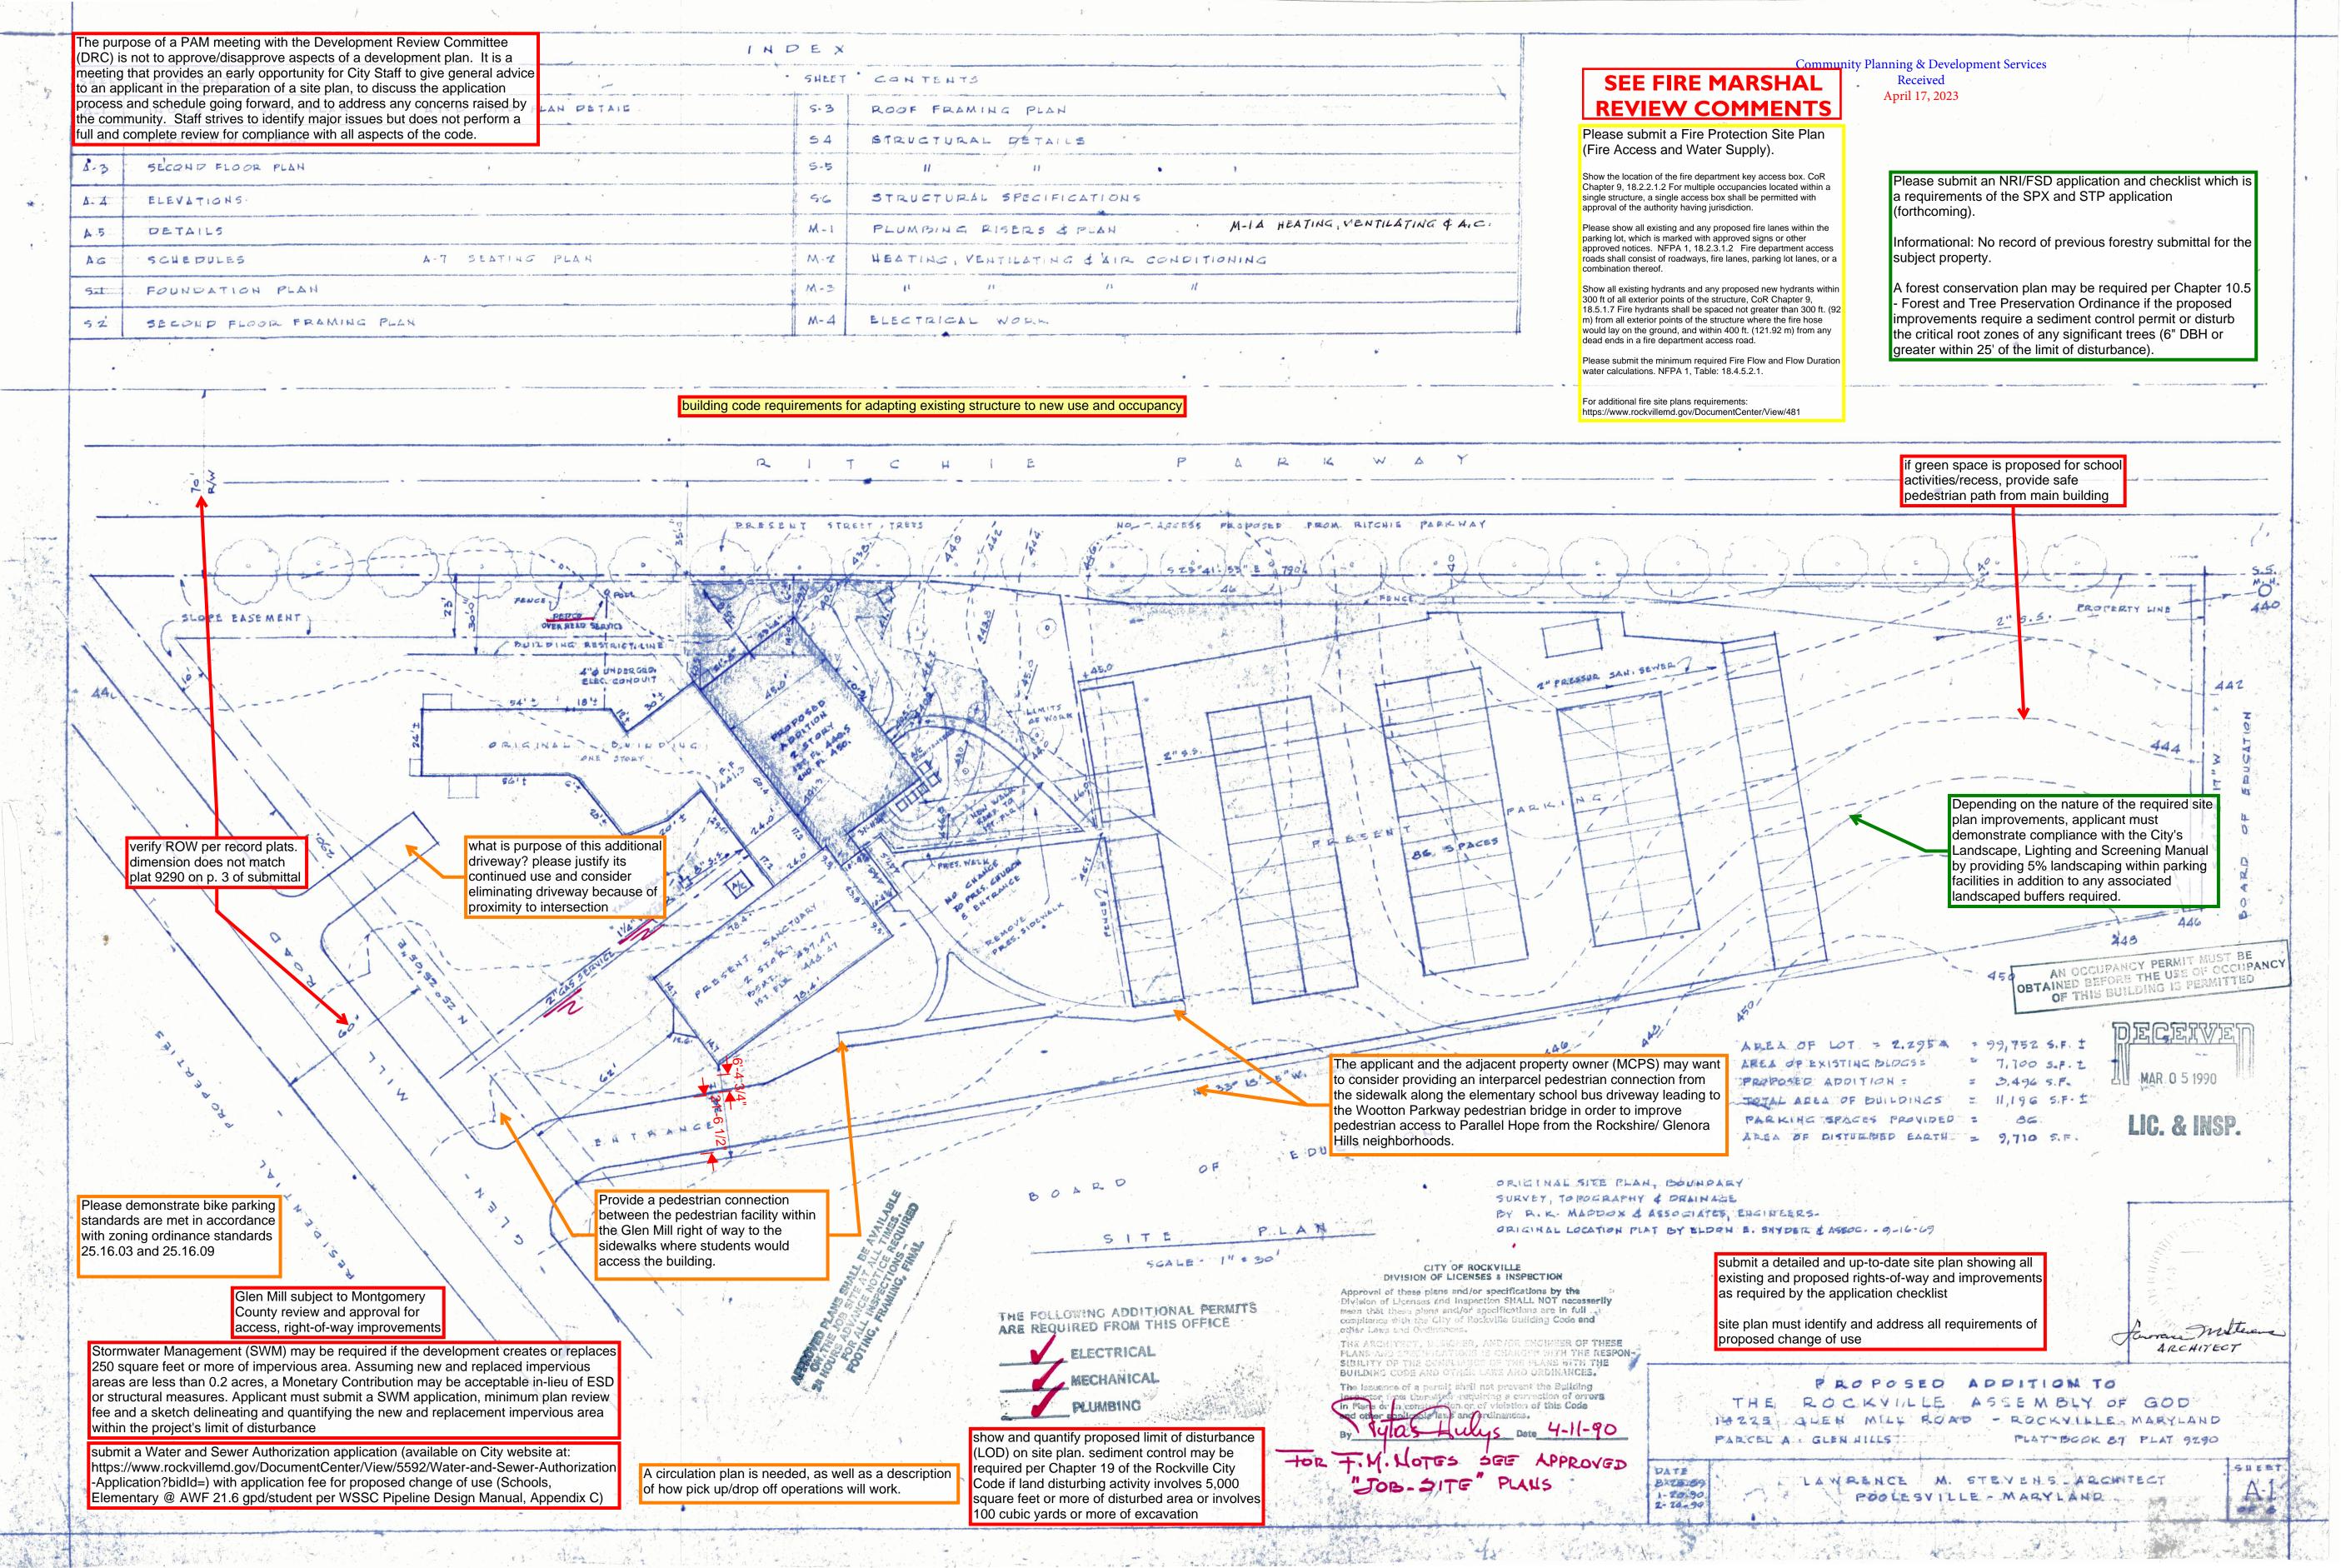



Please submit a Fire Protection Site Plan (Fire Access and Water Supply).

Show the location of the fire department key access box. CoR Chapter 9, 18.2.2.1.2 For multiple occupancies located within a single structure, a single access box shall be permitted with approval of the authority having jurisdiction.

Please show all existing and any proposed fire lanes within the parking lot, which is marked with approved signs or other approved notices. NFPA 1, 18.2.3.1.2 Fire department access roads shall consist of roadways, fire lanes, parking lot lanes, or a combination thereof.

Show all existing hydrants and any proposed new hydrants within 300 ft of all exterior points of the structure, CoR Chapter 9, 18.5.1.7 Fire hydrants shall be spaced not greater than 300 ft. from all exterior points of the structure where the fire hose would lay on the ground, and within 400 ft. from any dead ends in a fire department access road.

Please submit the minimum required Fire Flow and Flow Duration water calculations. NFPA 1, Table: 18.4.5.2.1.

For additional fire site plan requirements: https://www.rockvillemd.gov/DocumentCenter/View/481 Community Planning & Development Services
Received
03/22/2023



Comprehensive Transportation Review SCOPING INTAKE FORM

Project Name:						
Tojout Hame.	Parallel Hope Schools					
Permit No. (if	i didici riope conocis					
available):						
Subject Property						
Address:	14225 Glen Mill Road, Rockville, MD 20850					
Contact Person:						
	Annette Laguerre					
Contact Phone						
Number:	240.514.4475					
Contact Email						
Address:	alaguerre@parallelhope.com					
Proposed Land	Use			Square Footage/ Dwelling		
Use Density:				Units		
	Private educational institution based in a church. Enrollment not to exceed 75 children.			No dwelling units. Applicant will occupy approximately 1500 SF +/- in an 18,400 SF		
	Emeliment flot to exoced 75 children.			church building		
			١	Shurch bullain	lg	
		42		34		
Trip Generation	Peak Hour Site Trips 76					
-	Peak		OUT		TOTAL	
	Period	4			4	
	AM	71		60	131 *(see statement attached)	
	PM	0		0		
D 10: 1	SAT	0		0	•	
Proposed Study	See attached statement	9		11	20	
Area (Boundaries and Intersections)		3		11		
Proposed Access	Single ingress/egress driveway connecting to Glen Mill Road.					
Points:						
Duais ata d Hauina	No construction plants of Occasion is October 2000					
Projected Horizon (Build Out) Date:	No construction planned. Opening in September 2023 planned.					
Statement of	See attached statement	Because the proposed trips are above 30, a traffic stud				
Operations		required in accordance with city CTR standards. Staff				

Staff reviewed the ITE trip generation manual, using land use code 530, Private School (K-8), which is the closest to the proposed. The above markups reflect the anticipated trips.

Fees for transportation review include: Scoping Intake fee of \$200 and Transportation Report review fee of \$2000. Because the proposed trips are above 30, a traffic study is required in accordance with city CTR standards. Staff will need to meet with the applicant's traffic engineer to review the proposed trip distribution using the MNCPPC super district trip distribution patterns, and establish the scope for the study. Staff recommends the following intersections for study: the site's access on Glen Mill Road, Glen Mill/Wootton, Glen Mill/Darnestown, Dundee/Wootton, and Glen Mill/Lakewood School entrance. Staff also wants a safety and operational evaluation, including a peak queue analysis, of the Lakewood ES access and the church access since they are so close in proximity.