

III Maryland Avenue | Rockville, Maryland 20850-2364 | 240-314-5000 www.rockvillemd.gov

# **Development Review Comments**

April 9, 2024
PAM2024-00154
1st Submission Review Comments
205 Park Road

The following are Development Review comments from City of Rockville staff related to the project submission.

# **Reviewing Staff**

# Planning & Development Services (PDS)

### Project Manager:

Kimia Zolfagharian (KZ), Principal Planner kzolfagharian@rockvillemd.gov

### **Comprehensive Planning:**

Katie Gerbes (KG), Comprehensive Planning Manager kgerbes@rockvillemd.gov

### **Forestry Reviewer:**

Shaun Ryan (SR), Development Review Supervisor <a href="mailto:srvan@rockvillemd.gov">srvan@rockvillemd.gov</a>

#### Fire Reviewer:

Charles Biggus (CB), Fire Plans Examiner <a href="mailto:cbiggus@rockvillemd.gov">cbiggus@rockvillemd.gov</a>

### **Building Reviewer:**

Chris Dempwolf (CD), Buildings Plan Examiner Supervisor <a href="mailto:cdempwolf@rockvillemd.gov">cdempwolf@rockvillemd.gov</a>

# Dept. of Public Works (DPW)

### **Engineering Reviewer:**

Dave Waterman (DW), Senior Civil Engineer <a href="mailto:dwaterman@rockvillemd.gov">dwaterman@rockvillemd.gov</a>

### **Traffic and Transportation Reviewers:**

Andrew Luetkemeier (AWL), Principal Transportation Engineer <u>aluetkemier@rockvillemd.gov</u>

Faramarz Mokhtari (FM), Senior Transportation Planner <a href="mailto:fmokhtari@rockvillemd.gov">fmokhtari@rockvillemd.gov</a> PAM2024-00154 Development Review Letter April 9, 2024 Page 2

# Housing and Community Development (HCD)

### **Housing Reviewer:**

Punam Thukral (PT), Housing Specialist <a href="mailto:pthukral@rockvillemd.gov">pthukral@rockvillemd.gov</a>

# Recreation and Parks (RPD)

### **Parks Reviewer:**

Christine Henry (CH), Deputy Director <a href="mailto:chenry@rockvillemd.gov">chenry@rockvillemd.gov</a>

# Publicly Accessible Art in Private Development (AIPD) Reviewer:

Karyn Miller (KM), Arts, Culture, and History Program Manager <a href="mailto:kmiller@rockvillemd.gov">kmiller@rockvillemd.gov</a>

### **PDS Comments**

### Development & Zoning (KZ)

- 1. The purpose of a Pre-Application Meeting (PAM) with the Development Review Committee (DRC) is not to approve/disapprove aspects of a development plan. It is a meeting that provides an early opportunity for City Staff to give general advice to an applicant in the preparation of a site plan, project plan, or special exception, to discuss the application process and schedule going forward, and to address any concerns raised by the community. Staff strives to identify major issues but does not perform a full and complete review for compliance with all aspects of the code, which is done at the application phase.
  - a. The subject site is currently designated as RA Residential Attached land use by the Comprehensive Plan and is zoned Residential Medium Density (RMD)-Infill.
  - b. The existing property is located within the East Rockville Neighborhood.
  - c. Eight (8) Rowhouse Dwelling units are proposed.
  - d. A subdivision into two lots "Lot 1" and "Lot 2" are proposed.
  - e. Per Sec. 25.11.03 (Land use Tables), "Dwelling, Rowhouse" is a conditional use in the RMD-Infill zone, subject to the development standards in Section 25.11.05.
- 2. Per Sec. 25.07.02, the proposed development appears to have a point valuation of 7, as shown below:
  - a. Tract size of 1.1 to 2.5 acres = 1
  - b. 6 to 50 dwelling units = 2
  - c. No non-residential space = 0
  - d. Residential Impact Area = 3
  - e. Traffic Impact of fewer than 30 trips = 1
  - f. Points Total = 7
- 3. Land Use Planning Process:
  - A Level 2 Site Plan application, per Sec. 25.14.07.f (Site Plan Required) and Article 7 (Procedures for Site Plans) is required following finalization of PAM2024-00154. This application requires the following:
    - A valid approved Natural Resources Inventory (NRI) and Forest Stand Delineation (FSD) plan as set forth in the City's Environmental Guidelines.
  - b. Following approval of the Level 2 Site Plan application, a "signature set" will be required for final approval.
  - c. Any site which contemplates demolition of an existing building(s) must first file and received approval of an Evaluation of Significance application with Historic District Commission (HDC) prior to any demolition occurring.
- 4. Land Use Review Timelines:

- a. Level 2 Site Plan: initial submittal review is 6 weeks; subsequent reviews are 3-4 weeks; final submittal due 5 weeks before the initial Planning Commission hearing.
- b. Level 2 Site Plan Signature Set: initial submittal review is 2 weeks; subsequent reviews are 1-2 weeks.
- c. Total typical review timeline is highly variable depending on applicant submittal timelines and responsiveness to City comments and requests.
- 5. The Zoning Ordinance Rewrite (ZOR) project is underway and is anticipated to be adopted and become effective in Fall 2025. This project is expected to revise a number of zoning and use standards across the city.
- 6. The Property is currently improved with a single-family detached dwelling constructed in 1941. The existing driveway is located off the Property's Park Road frontage.
- 7. Per Section 25.11.02 a maximum of four dwelling units per lot are permitted.
- 8. Per Section 25.11.10.5 Not more than eight (8) surface parking spaces are allowed in a single row unless planted separator islands or swales are provided.
- 9. Per Section 25.11.10.6 Where surface parking of between three (3) and six (6) contiguous parking spaces is provided, screening must be provided around the entire perimeter of the surface parking area. The screening must be evergreen hedges or evergreen trees that are thickly planted and maintained, and at least forty-two (42) inches in height when planted. For parking facilities, the landscaping standards of Section 4.d of the Landscaping, Screening, and Lighting Manual apply.
- 10. Parking for each unit must be provided on the same lot.
- 11. Provide an outline of how guest parking will be accommodated with the proposed development.
- 12. Provide the percentage of impervious surface located in the front yard area of the subject property.
- 13. Provide elevations, rendered site plans, and additional rendered exhibits depicting the proposed design of the rowhouses, how they consider the East Rockville Neighborhood Design Guidelines and the architectural character of the surrounding area.
- 14. See plan markups for additional comments.

# Comprehensive Planning (KG)

1. Per Section 25.14.01.c of the Rockville Zoning Ordinance, any structure in Rockville proposed for demolition must undergo an Evaluation of Significance by the Historic District Commission prior to demolition taking place. Typically, the Historic District Commission meets once per month, on the third Thursday of the month. Please contact <a href="https://district.nih.gov">history@rockvillemd.gov</a> for any questions about the

Evaluation of Significance process, or to receive/submit an application for review by the Historic District Commission.

- 2. This application is generally compliant with the City's Comprehensive Plan. The application is located within Planning Area 2 and is further identified as Focus Area 8. The following statements within the Planning Area 2 chapter of the Comprehensive Plan are consistent with the project application:
  - "Rezone the properties from R-60 (Single Unit Detached Dwelling) to a zone that promotes a mix of infill housing types, compatible in scale with single-family homes, including duplexes, triplexes, fourplexes, and townhouses/row houses. Multiplexes of greater than four units are not appropriate in this area." page 273. Though this application is not rezoning the property, the proposed use is consistent with the vision of the Comprehensive Plan.
  - "New buildings should blend well with the surrounding residential detached neighborhood, transition well in scale, mass, and height to surrounding homes, provide enhanced connections to the Rockville Metro Station, and limit curb cuts on Park Road so as to focus vehicular access and parking to the rear of the building." page 273. Townhouses will likely blend in terms of scale, mass and height to the existing neighborhood, and the application does not propose any additional curb cuts.
  - "In general, parking areas should be set back behind front building lines, away from the public realm and screened from public view. For attached dwellings, rear garage access is preferred, whether the garage is integrated into the primary structure or whether it is a separate structure. Avoid front-loaded garages whenever possible. For multiunit dwellings, parking requirements should take into account the area's transit proximity." page 273. This application proposing locating parking at the rear of the lot, away from the public realm and front building lined. From loaded garages are not being proposed.
- 3. In addition to the consistencies already noted, there are some urban design recommendations within the Comprehensive Plan that this application does not currently provide details on. Staff encourage the applicant to consider the following design elements to their plan when moving beyond the Pre-Application Meeting phase:
  - "Exterior lighting for new buildings should utilize a cutoff design to minimize light spillover onto surrounding properties." page 273.
  - "Encourage an architecturally enhanced feature at the corner of North Stonestreet Avenue and Park Road by focusing new development at that intersection, incorporating high-quality design components, and improved public realm." page 273.
  - "Explore burying utility lines at the time of new development and/or street and sidewalk reconstruction." page 273.
  - "Incorporate community use space, including plazas and outdoor green space, into the overall redevelopment concept." page 273.

• "Provide upgraded pedestrian and bicycle connections to the surrounding neighborhoods and to the Rockville Transit Station." - page 273.

### Forestry (SR)

1. See plan mark-up for comments.

### Fire (CB)

1. See plan mark-up for comments.

### **Building (CD)**

1. See plan mark-up for comments.

## **DPW Comments**

### Engineering (DW)

1. See plan mark-up for comments.

### Traffic and Transportation (AWL/FM)

- 1. Please see site plan markup for comments
- 2. Please provide turning templates and turn around for loading and to the proposed trash area. The submitted on-site report does not include this information.
- 3. Please make sure the submitted plan to include cross sections for existing frontage roads.
- 4. Fees for the scoping intake and on-site report of \$200 and \$1000, respectively are due for to this application.

## **HCD Comments**

## Housing (PT)

The applicant is proposing for the redevelopment of the site for the construction of eight (8) townhouse dwelling units, proposing less than 50 units, so this project doesn't require to comply with MPDU regulations chapter 13.5 of city code.

## **RPD Comments**

### **Recreation and Parks**


1. During construction make sure artwork is protected. See below location of artwork.



**Publicly Accessible Art in Private Development (KM)** 

1. New residential construction projects consisting of a total of less than ten (10) dwelling units are exempt from the Publicly Accessible Art in Private Development requirement.

Note: At the time of the next submittal, the applicant will need to provide a point- by-point response letter noting how the staff review comments have been addressed. Comments provided in letter format can be addressed letter format. Comments provided in the plans should be addressed via plan markups rather than letter format. See attached example.

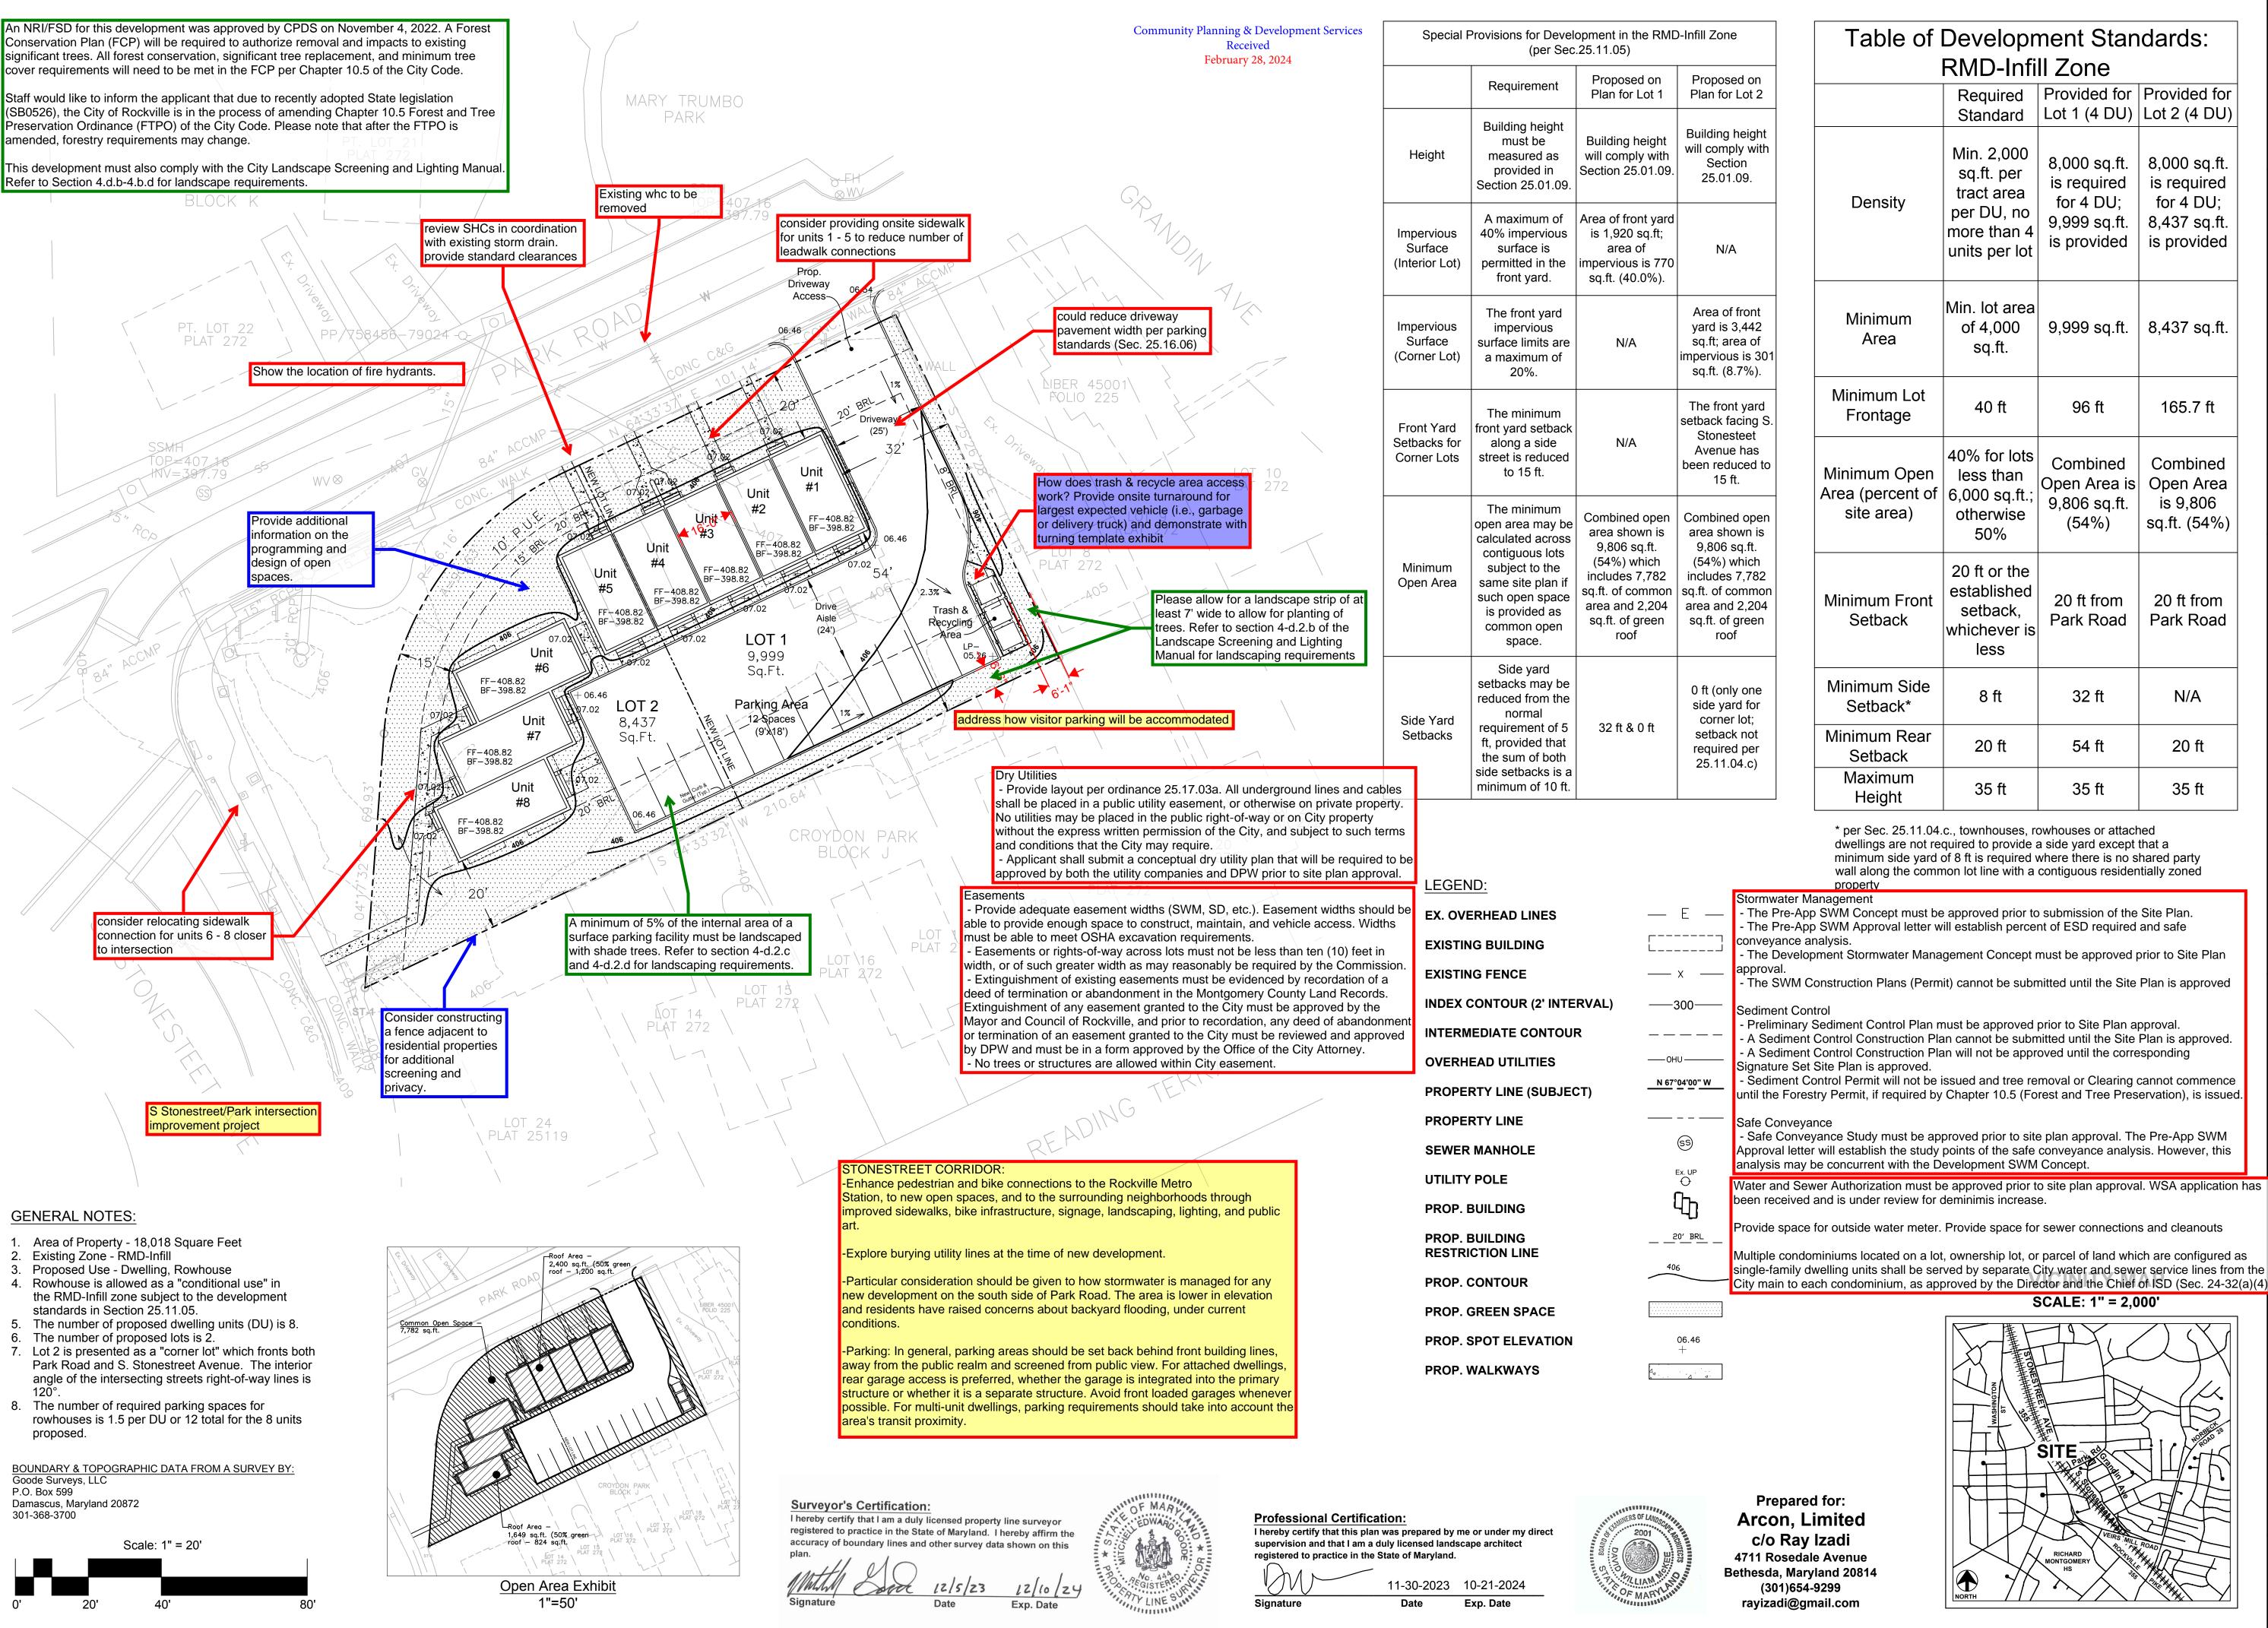

**Table of Development Standards:** RMD-Infill Zone Provided for Provided for Standard Lot 1 (4 DU) Lot 2 (4 DU) 8,000 sq.ft. | 8,000 sq.ft. is required is required for 4 DU; for 4 DU; 9,999 sq.ft. 8,437 sq.ft. is provided is provided 9,999 sq.ft. | 8,437 sq.ft. 165.7 ft 96 ft Combined Combined Open Area is Open Area 9,806 sq.ft. is 9,806 sq.ft. (54%) (54%)20 ft from 20 ft from Park Road Park Road 32 ft N/A 20 ft 54 ft

\* per Sec. 25.11.04.c., townhouses, rowhouses or attached dwellings are not required to provide a side yard except that a minimum side yard of 8 ft is required where there is no shared party wall along the common lot line with a contiguous residentially zoned

35 ft

- The Pre-App SWM Concept must be approved prior to submission of the Site Plan. - The Pre-App SWM Approval letter will establish percent of ESD required and safe

- The Development Stormwater Management Concept must be approved prior to Site Plan

- The SWM Construction Plans (Permit) cannot be submitted until the Site Plan is approved


- Preliminary Sediment Control Plan must be approved prior to Site Plan approval. - A Sediment Control Construction Plan cannot be submitted until the Site Plan is approved. - A Sediment Control Construction Plan will not be approved until the corresponding


until the Forestry Permit, if required by Chapter 10.5 (Forest and Tree Preservation), is issued.

Approval letter will establish the study points of the safe conveyance analysis. However, this analysis may be concurrent with the Development SWM Concept.


Provide space for outside water meter. Provide space for sewer connections and cleanouts

Multiple condominiums located on a lot, ownership lot, or parcel of land which are configured as single-family dwelling units shall be served by separate City water and sewer service lines from the City main to each condominium, as approved by the Director and the Chief of ISD (Sec. 24-32(a)(4)

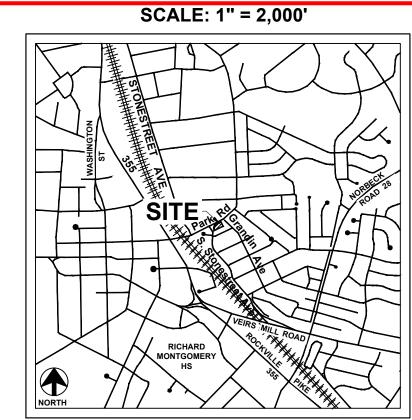

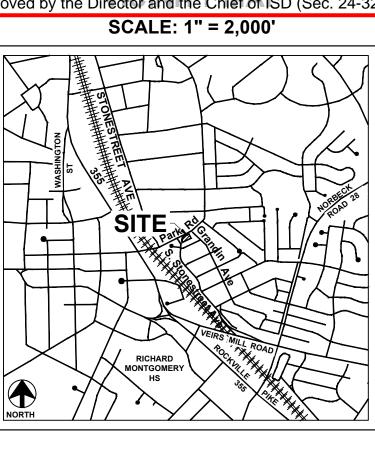

Revisions

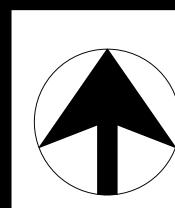



35 ft

WSSC GRID 218NW07 TAX MAP: GR342

SHEET 1 OF 1